HELAN

Crisplant a/s

Costumer	:	Standard drawing
Project description	:	PC to P-NET Interface
Drawing Number	:	1002724R01
Subject	:	FOR CUC

Placement	:	Line voltage, freq.	:
Speciel terms	:	Control voltage	:
Norm/standards	:	Power consumption.	:
Capsuling Class	:	Rated current	:
Ambient temperature	:	Short-circuit Ikmax.	:
Relative humidity	:	Short-circuit Ikmin.	:
Distribution system	:	Main cable	:
Cubicles	:	Incoming cable	:
Fabrication year	: 2002	Outgoing cables	:

Project start	: 20.Aug.2002	Largest page no.	: 10
Project responsible	: EJE	Total pages	: 5
Latest change	: 11.Okt.2002		
Latest Constructor	: MBP		

Title	TAVLESPECIFICATION	Drawn	App.	Rev.	Date	Drawing No.	Cont. page 2
Subject	FOR CUC	20.Aug.2002			17.Nov.1999	1002724R01	
Project	PC to P-NET Interface	Plotted 15.Nov.2002	Eng. EJE				Page no. 1
			Drw. MBP				

Page overview

Page	Page description	Page Addition	Date	Construc.
1	TAVLESPECIFICATION		17. Nov. 1999	MBP
2	CONTENTS		20. Aug. 2002	KHO
3	REVISIONS		20. Aug. 2002	MBP
6	LAYOUT		20. Aug. 2002	KHO
10	POWER SUPPLY		20. Aug. 2002	MBP

1

Title	CONTENTS	Drawn	20. Aug. 2002	App.		Rev. / Date	Drawing No. 1002724R01 / Cont. page 3
Subject	FOR CUC	Plotted	15. Nov. 2002	Eng.	EJE	20. Aug. 2002	Page no. 2
Project	PC to P-NET Interface			Drw.	KHO		


Crisplant a/s

REVISIONS.

Rev.	Date	Engineer	Changes made	Changed pages
A	20-aug-2002	KHO	As built	All

Title	REVISIONS	Drawn 20. Aug. 2002	App.	Rev.	Date	Crisplant a/s	Drawing No. 1002724R01	Cont. page 6
Subject	FOR CUC	Plotted 15. Nov. 2002	Eng. EJE		20. Aug. 2002			Page no. 3
Project	PC to P-NET Interface		Drw. MBP					


FIBOX 250x160x125

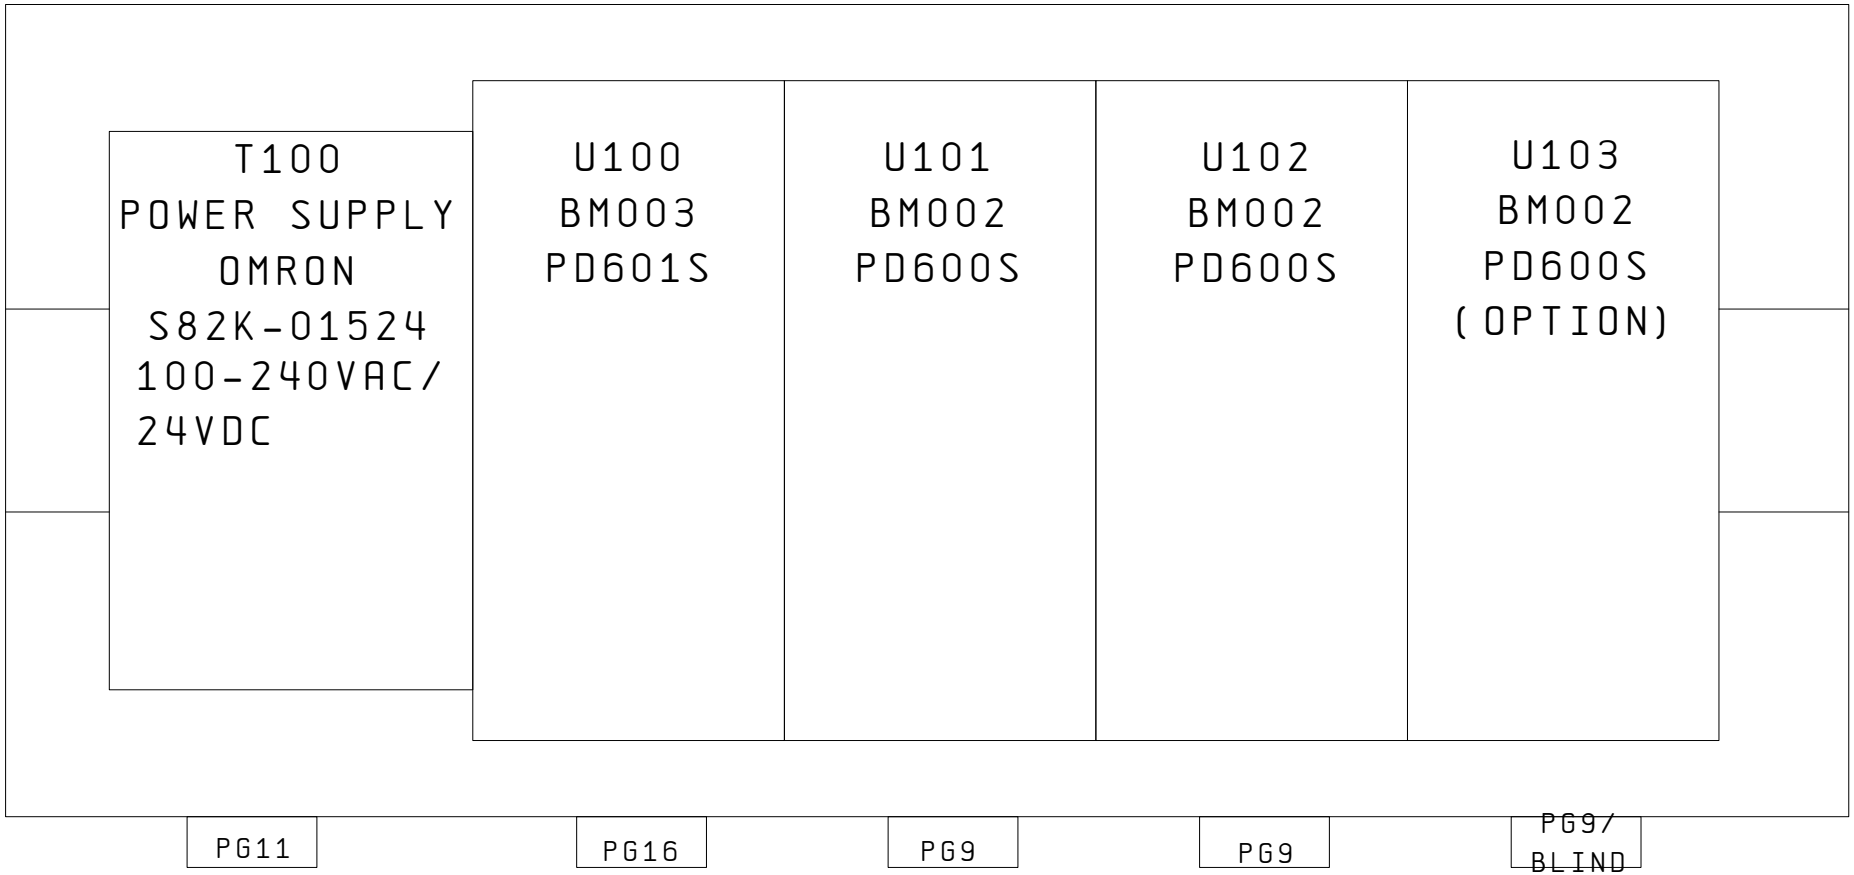

3

Title	LAYOUT	Drawn	20. Aug. 2002	App.		Rev.	Date	Drawing No. 1002724R01	Cont. page 10
Subject	FOR CUC	Plotted	15. Nov. 2002	Eng.	EJE		11. Okt. 2002		Page no. 6
Project	PC to P-NET Interface			Drw.	KHO				

Crisplant a/s

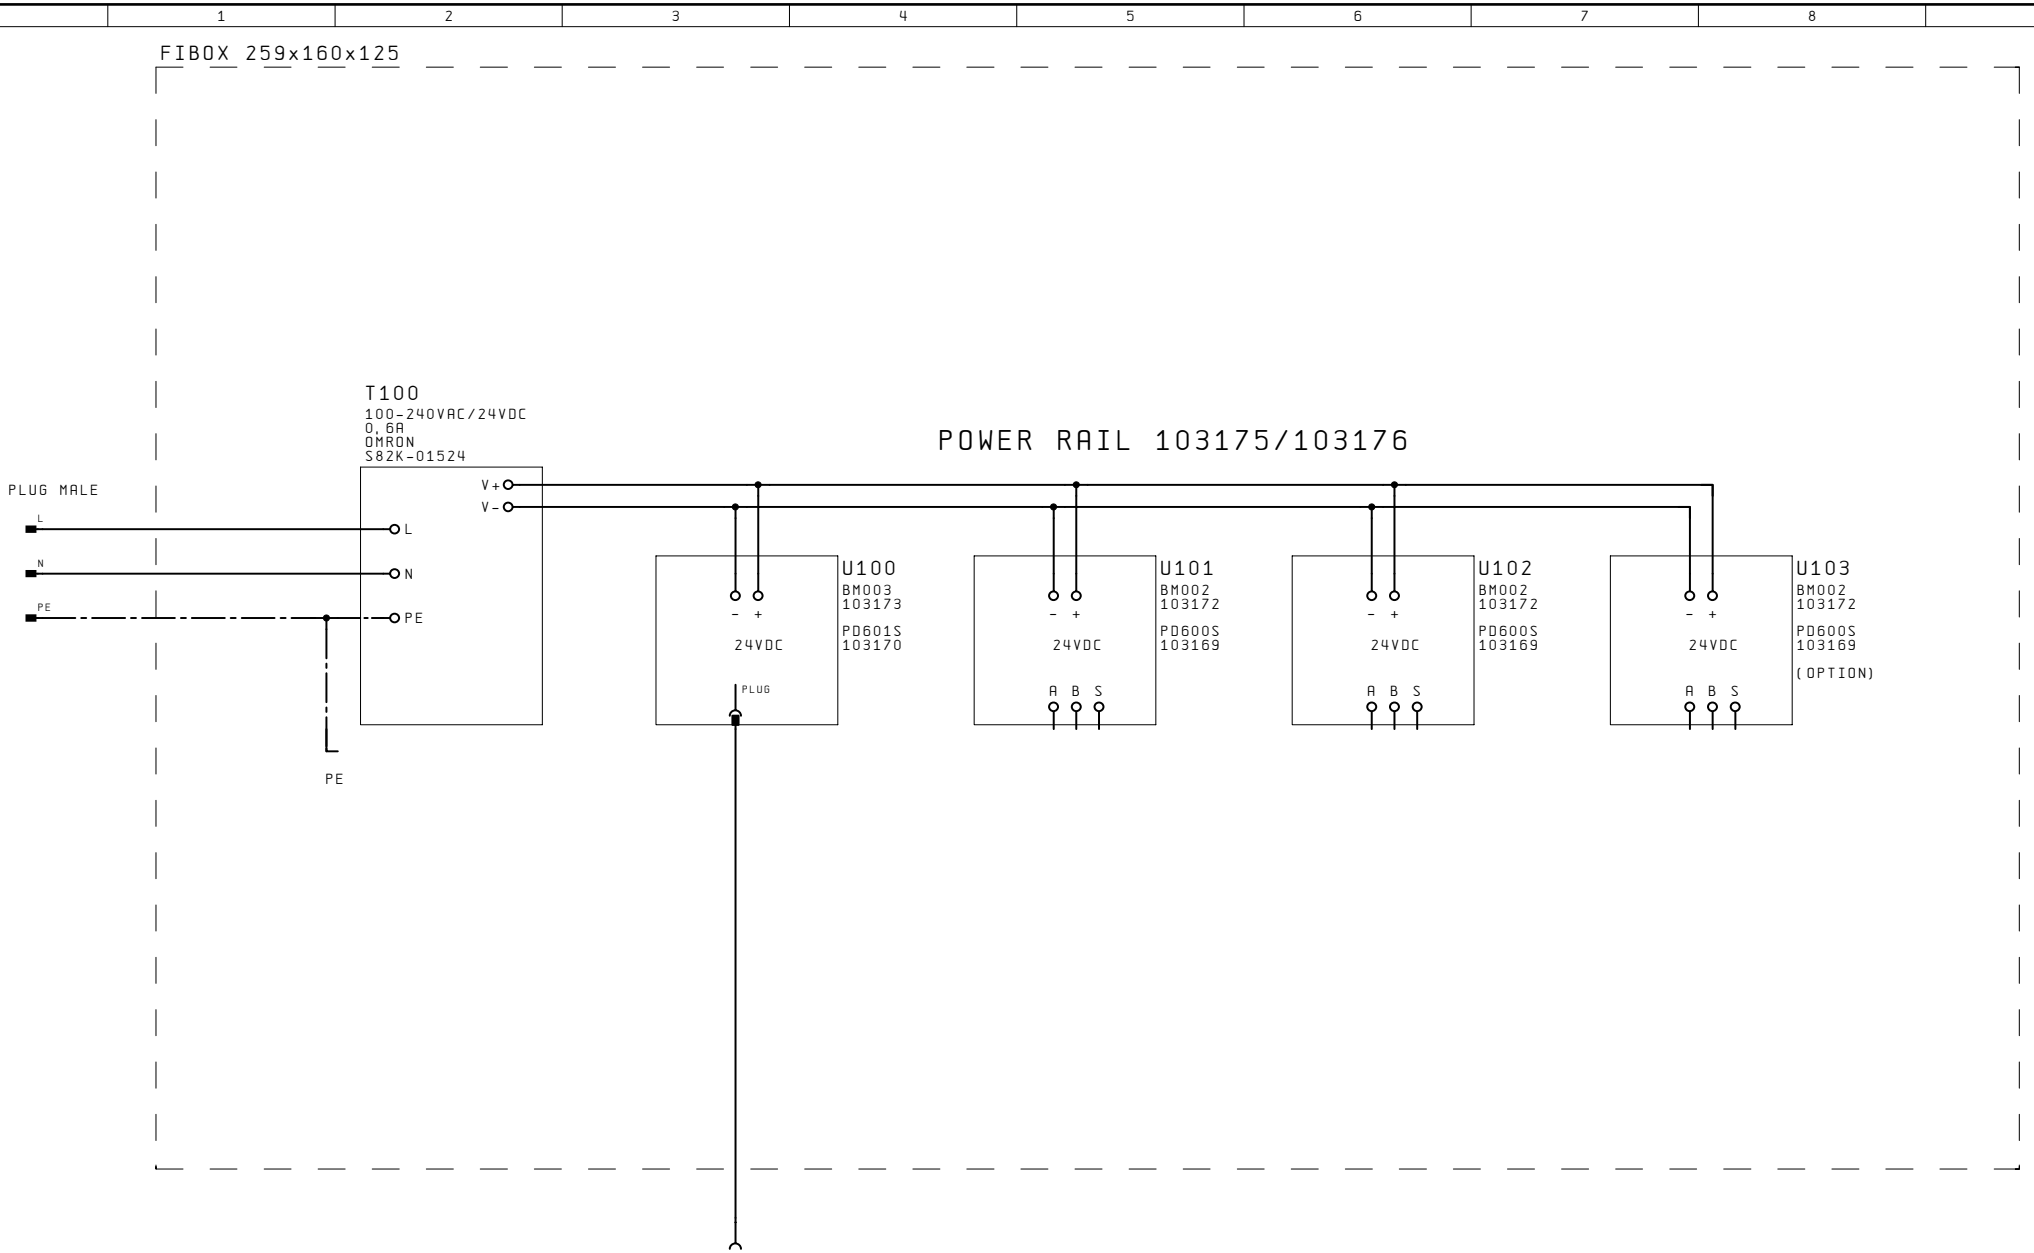

6

Title	POWER SUPPLY	Drawn 20. Aug. 2002	App.	Rev.	Date	Crisplant a/s	Drawing No. 1002724R01	Cont. page
Subject	FOR CUC	Plotted 15. Nov. 2002	Eng. EJE		21. Aug. 2002			Page no. 10
Project	PC to P-NET Interface		Drw. MBP					